

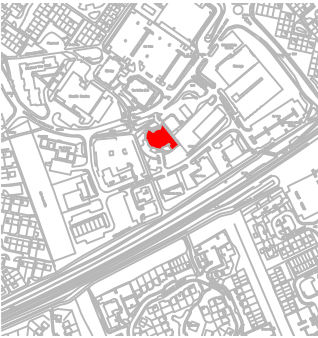


- 1 - Tour Start
- 2 - Ability Centre Support Service
- 3 - Library/CIS
- 4 - Bookbug Session
- 5 - Boardmaker Demonstration
- 6 - MacMillan Cancer Support
- 7 - Supported Employment Service
- 8 - Film - Livingston at 60
- 9 - Café


OS Plan reproduced from Ordnance Survey mapping with the permission of the controller of Her Majesty's Stationery Office. Crown Copyright. Unauthorised reproduction infringes Crown copyright and may lead to prosecution or civil proceedings. West Lothian Council copyright Service LAG002.

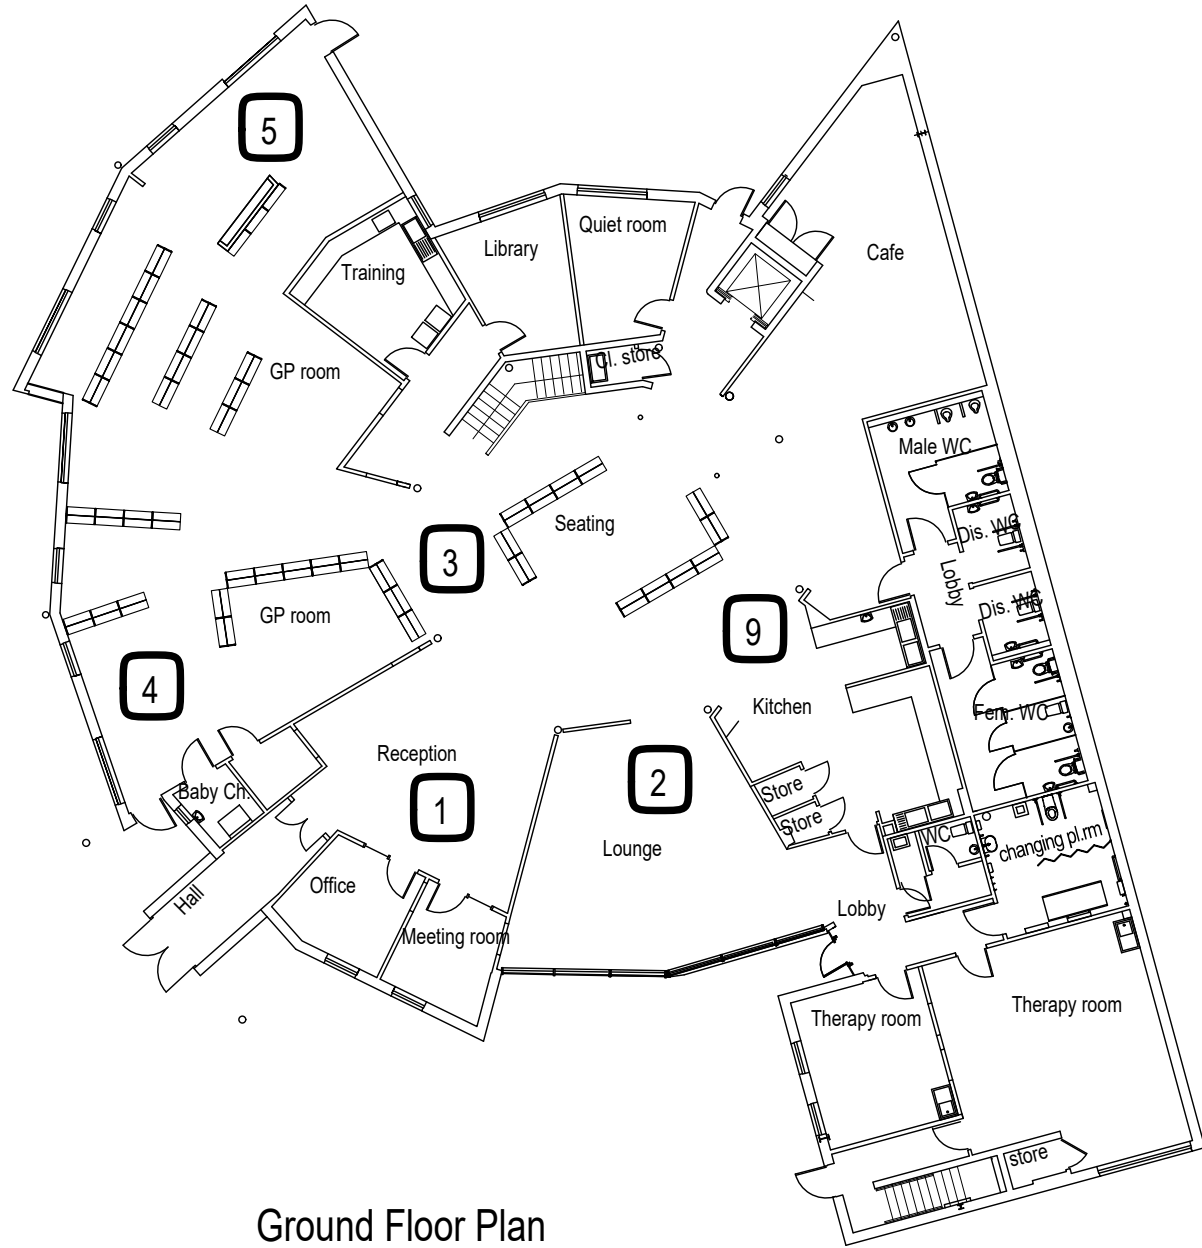

Location Plan

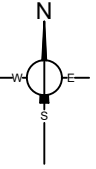

Ground Floor Plan

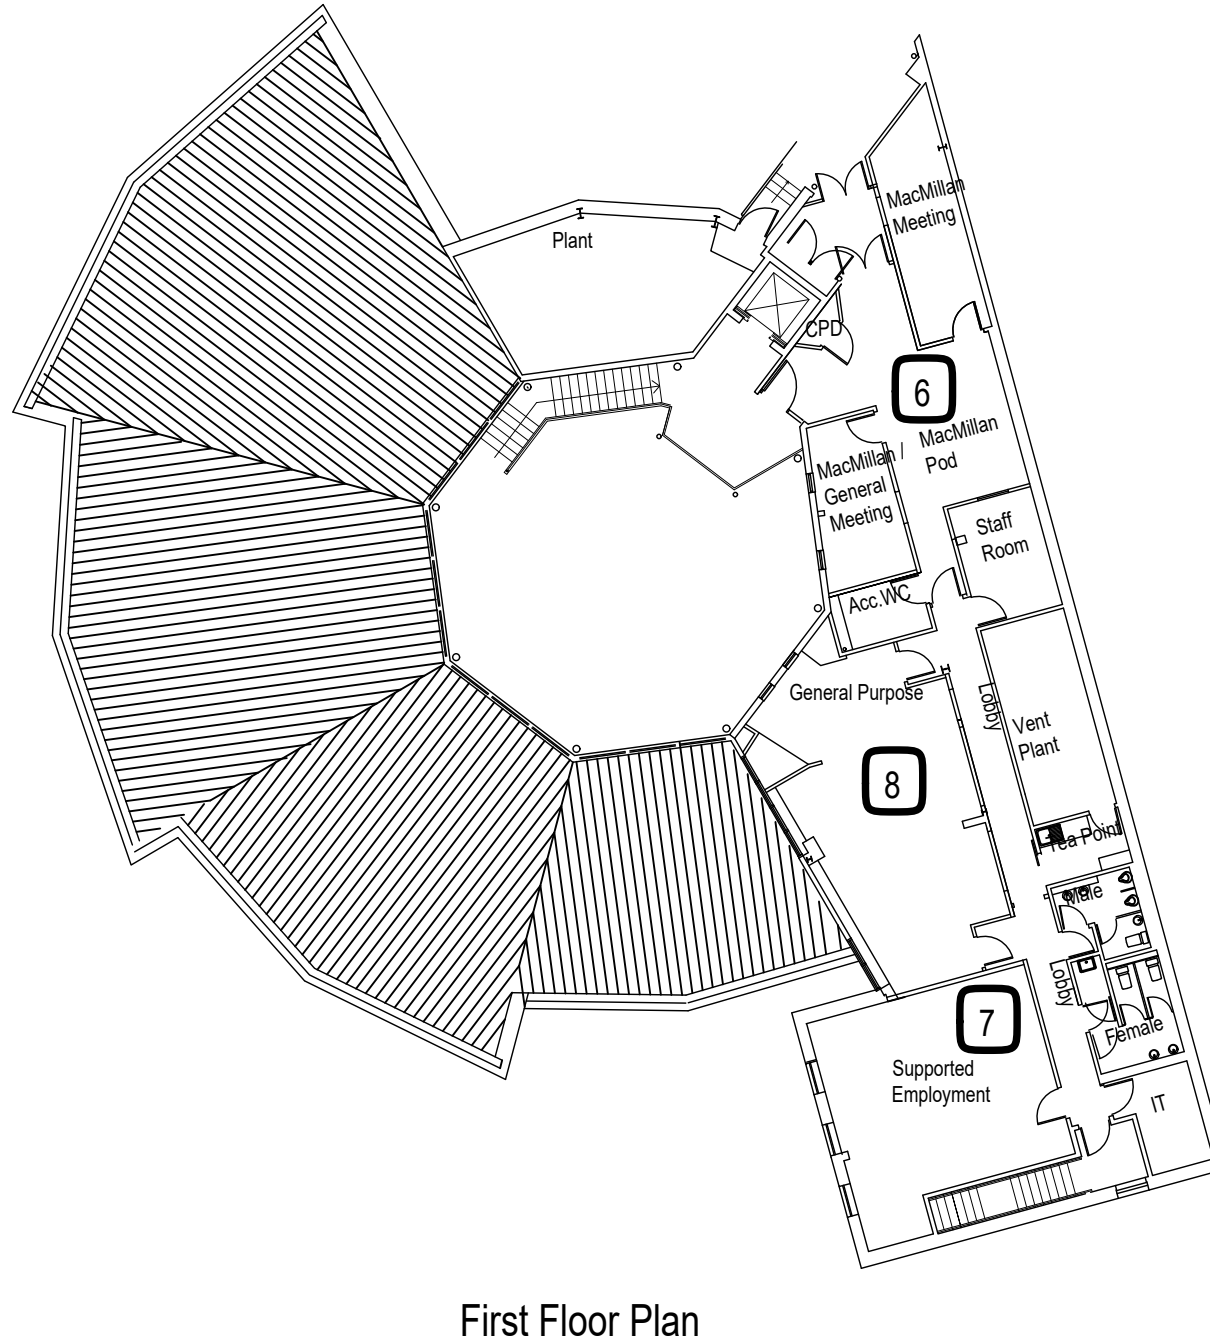

First Floor Plan

### GENERAL LAYOUT PLAN

NOTE: THIS DRAWING IS NOT A MEASURED SURVEY. IT IS DRAWN UP FROM RECORD PLANS

Rev	date	details	A3 sheet
Status		AS BUILT	
<p><b>Property Services</b>            Finance &amp; Property Services            West Lothian Civic Centre            Howden South Road, Livingston EH54 6FF</p>			
<p><b>Project</b>            Livingston North Partnership Centre            Carmondean Centre South            Deans, Livingston            EH54 8PT</p>			
<p><b>Drawing</b>            LOCATION PLAN            FLOOR PLAN</p>			
date	scale(s)	drawn	Check
JAN 17	1:250	ST	DW
property no.	drawing no.	Rev	
98212	***	***	

Not to Scale